

North 0 5 10 20 40


This suite has not been field
verified by Veenendaal Cave, Inc.

**PEACHTREE
CENTER**



South Tower • Suite 2000 • 14,562 RSF

As Built

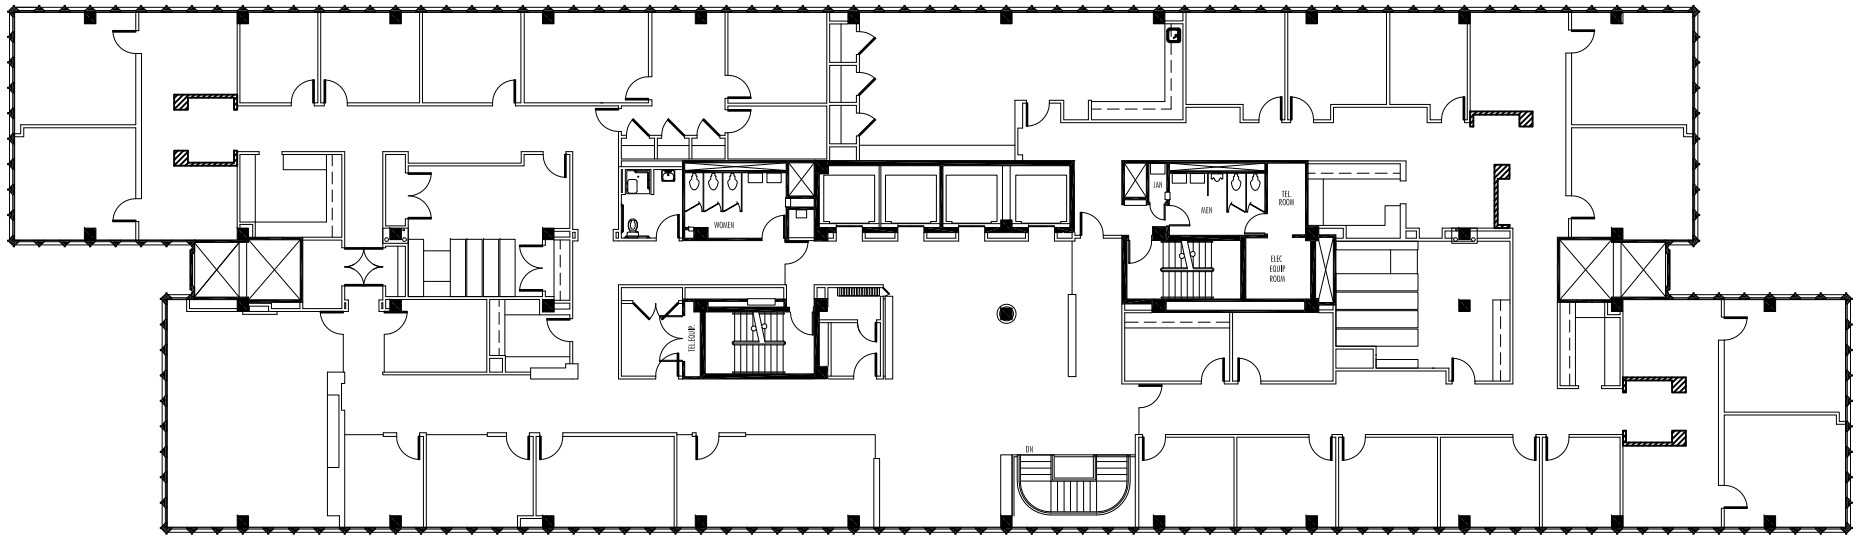

North 0 5 10 20 40


This suite has not been field
verified by Veenendaal Cave, Inc.

PEACHTREE
CENTER



South Tower • Suite 2100 • 14,562 RSF

As Built

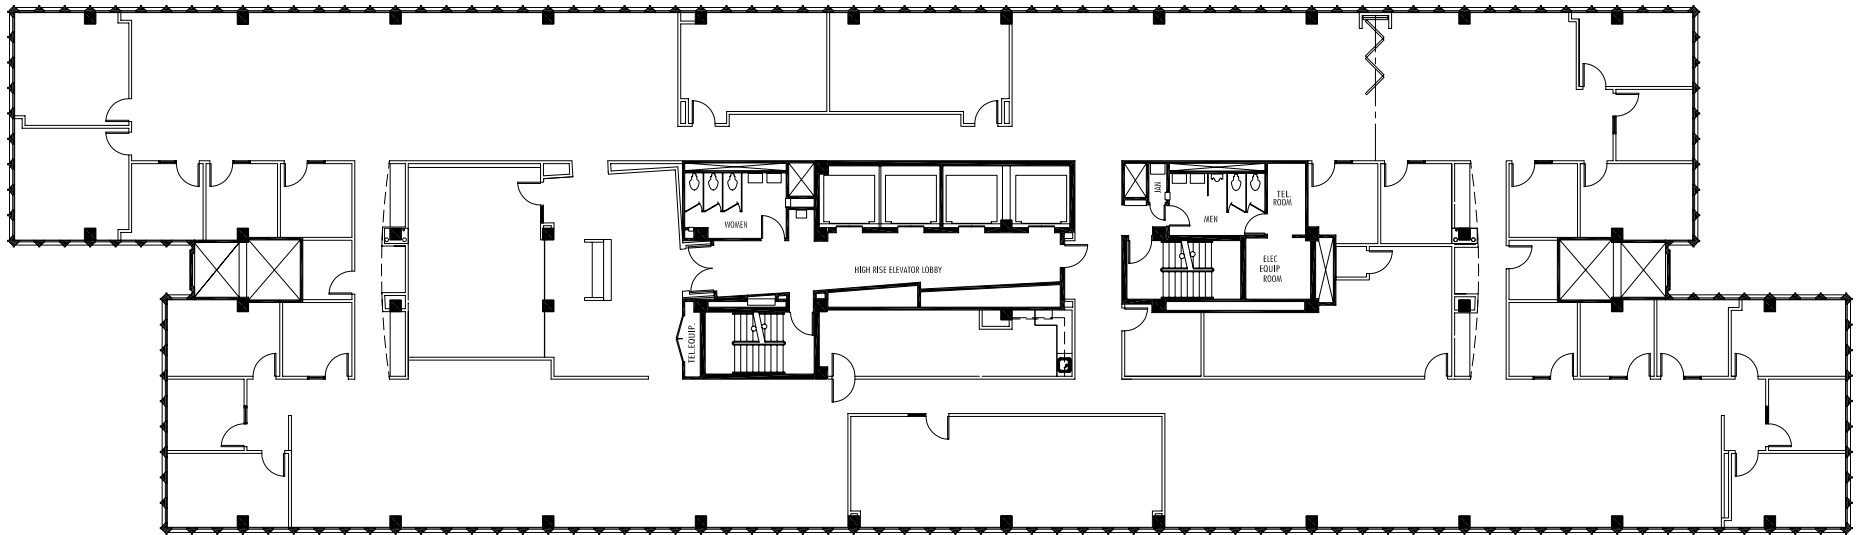

Not To Scale



North 0 5 10 20 40

PEACHTREE
CENTER



South Tower • Suite 2200 • 14,562 RSF

As Built