


North




This suite has not been field verified by NELSON

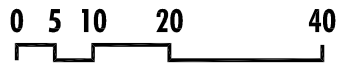


**NELSON** Tower 225 • 20th Floor • 14,562 RSF

**As Built**

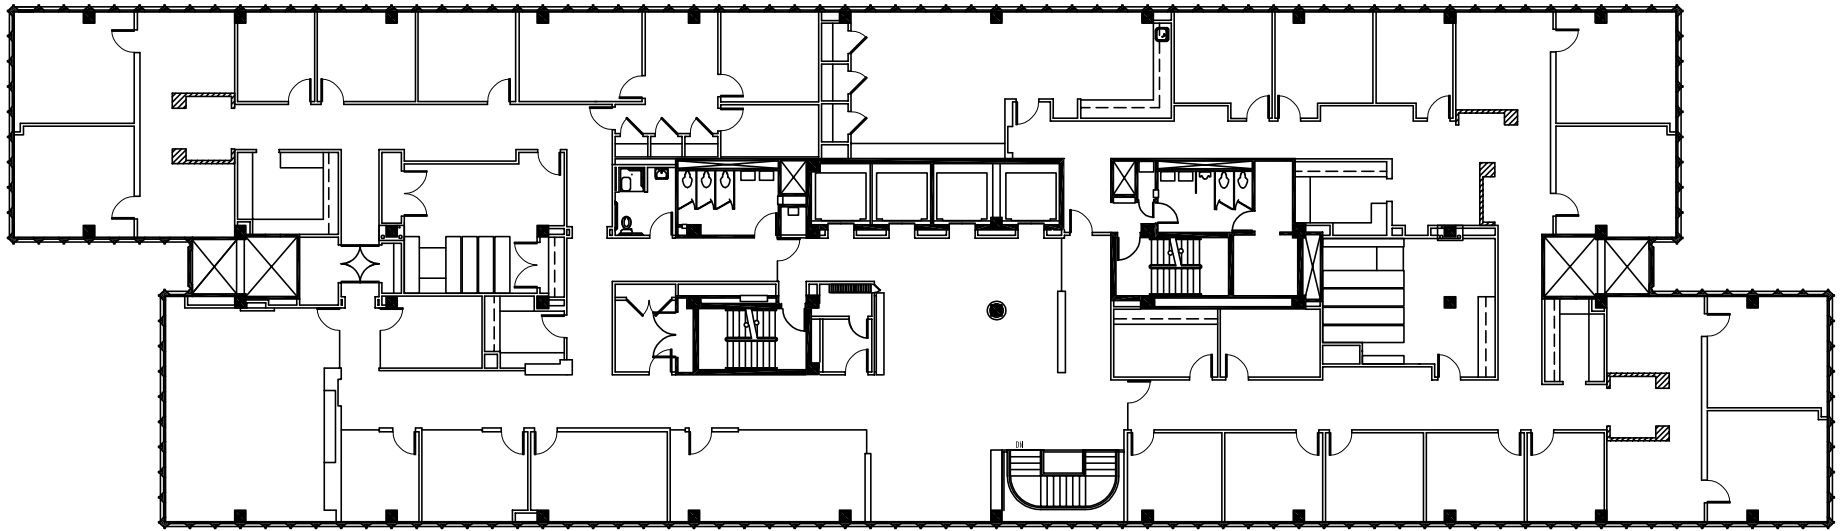

North

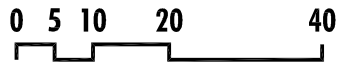


This suite has not been field verified by NELSON




PEACHTREE  
CENTER

**NELSON** Tower 225 • 21st Floor • 14,562 RSF

**As Built**

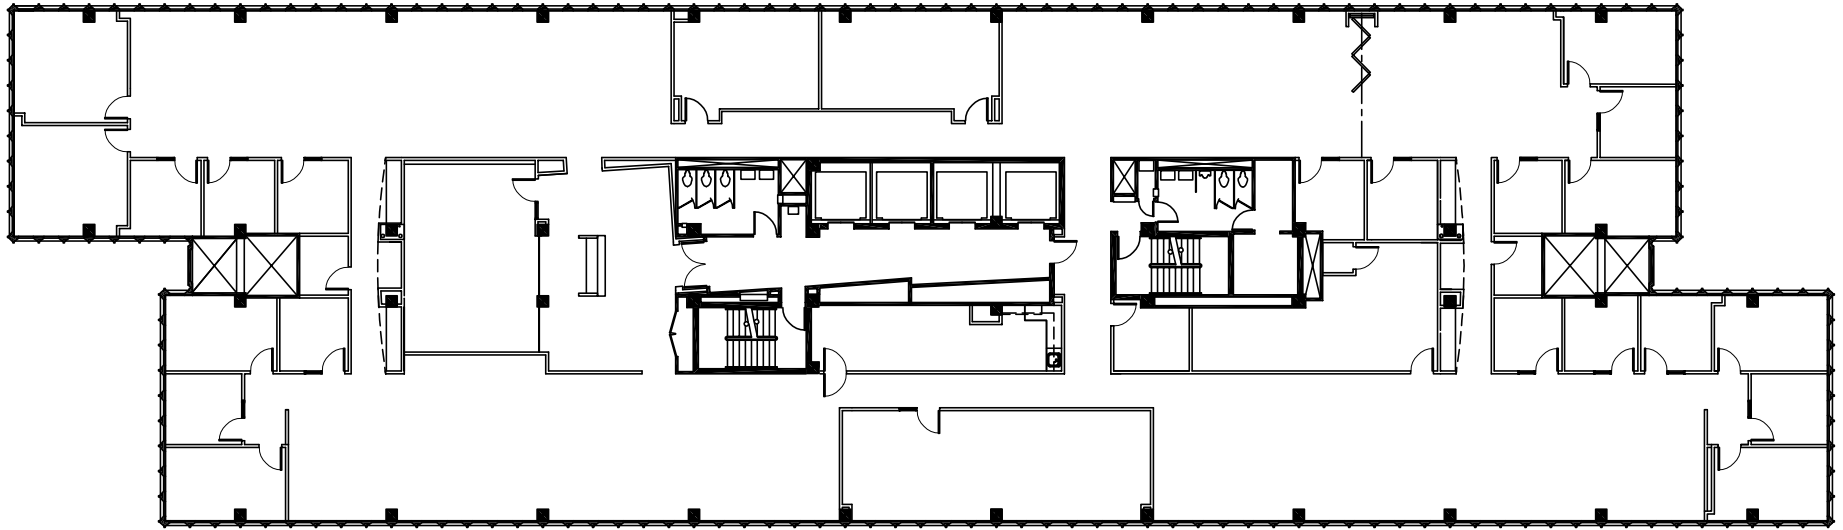

North

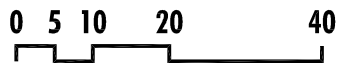

This suite has not been field verified by NELSON



PEACHTREE  
CENTER

**NELSON** Tower 225 • 22nd Floor • 14,562 RSF

**As Built**