



North

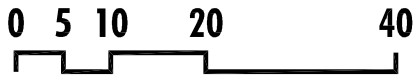


PEACHTREE  
CENTER

**NELSON** Tower 233 • Suite 1900 • 16,191 RSF

**As Built**

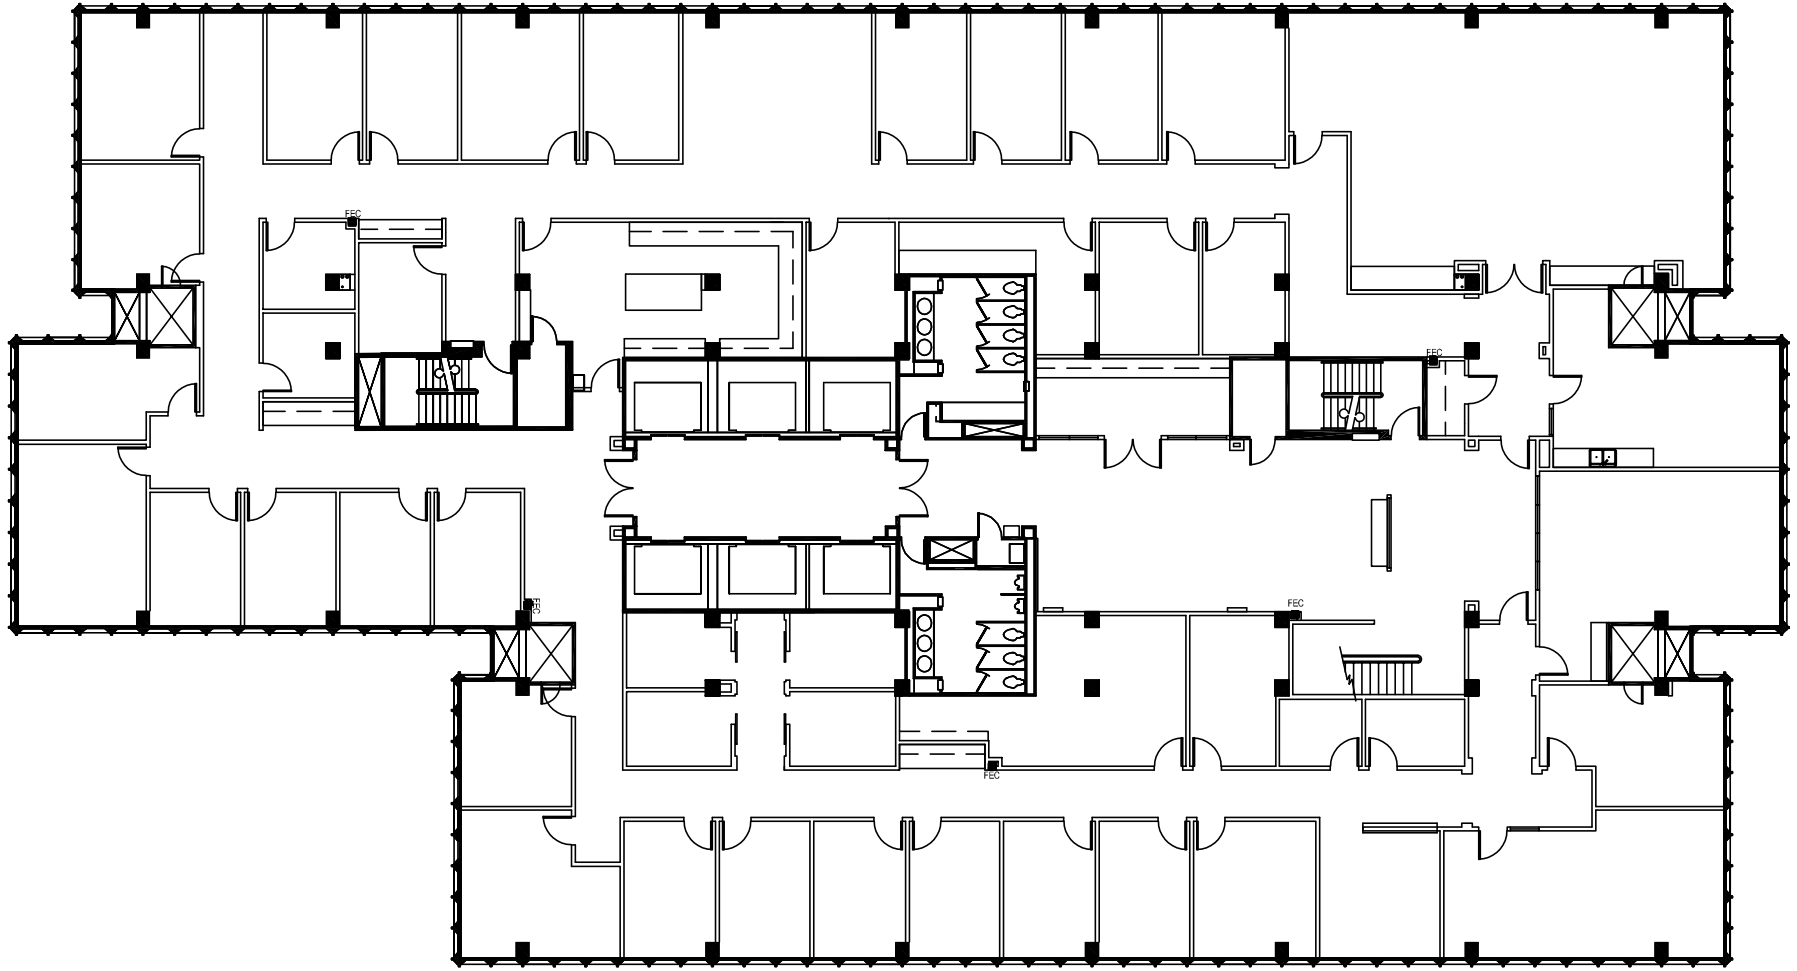


North

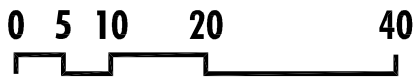


PEACHTREE  
CENTER

**NELSON** Tower 233 • Suite 2000 • 16,191 RSF

**As Built**

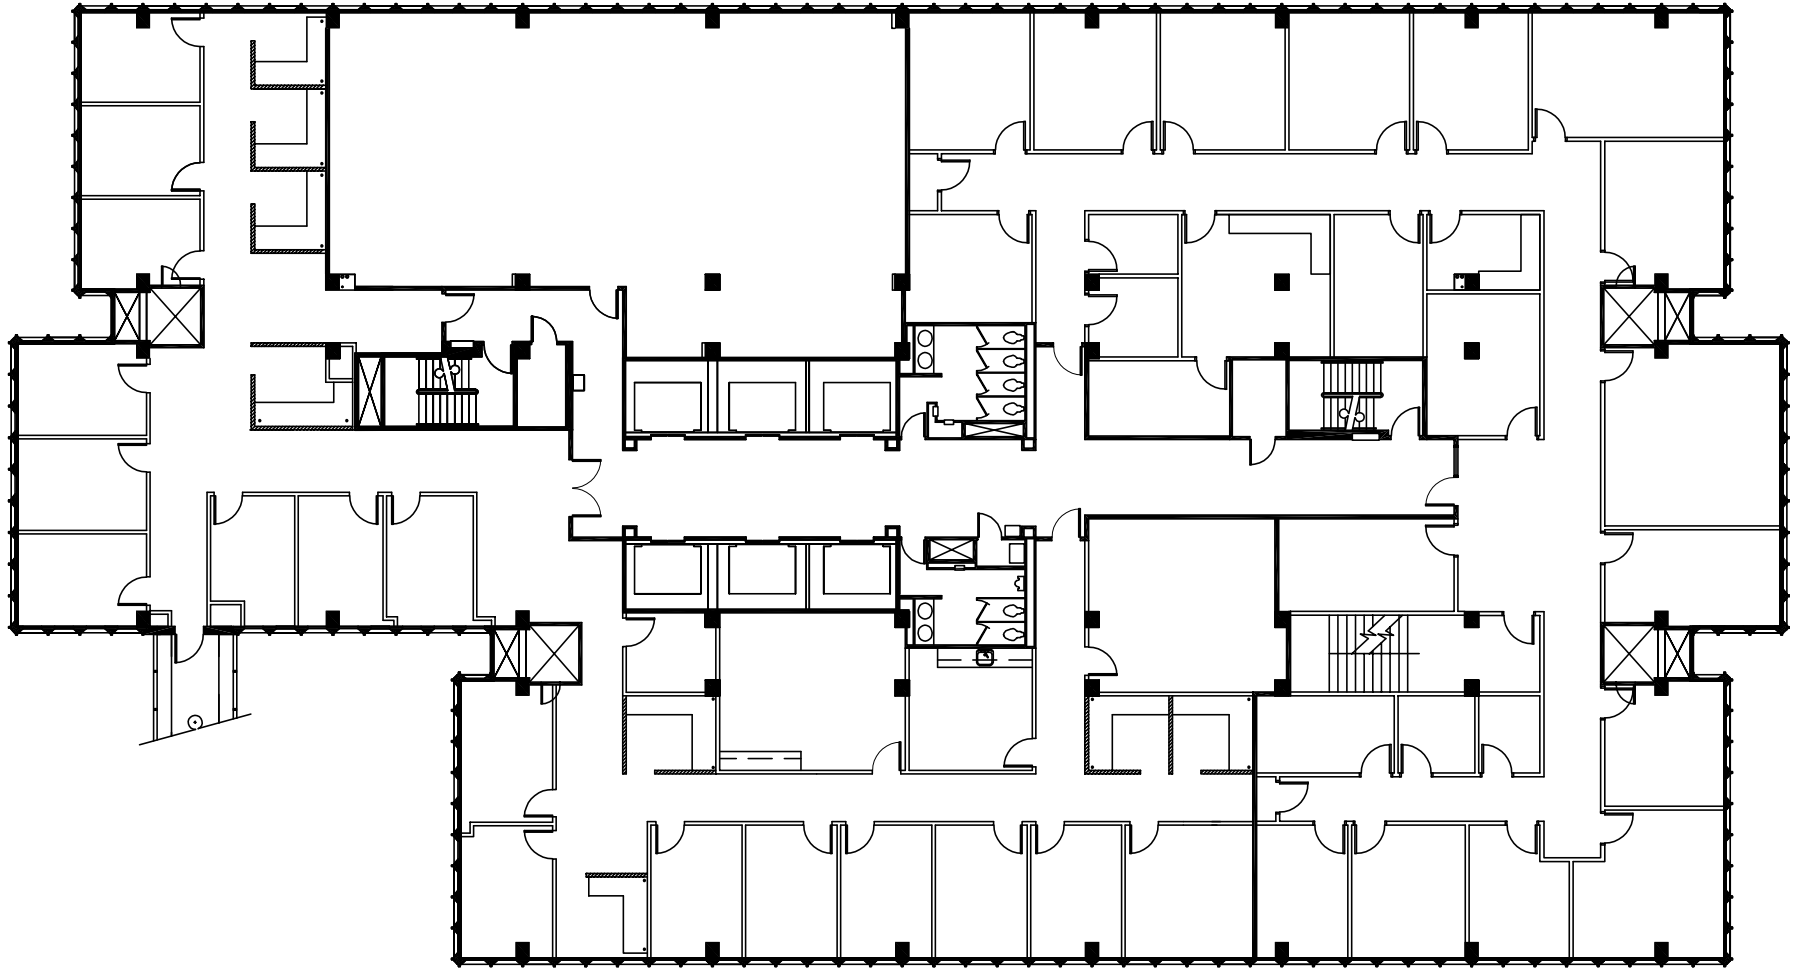


North

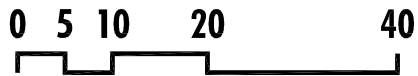


PEACHTREE  
CENTER

**NELSON** Tower 233 • Suite 2100 • 16,191 RSF

**As Built**

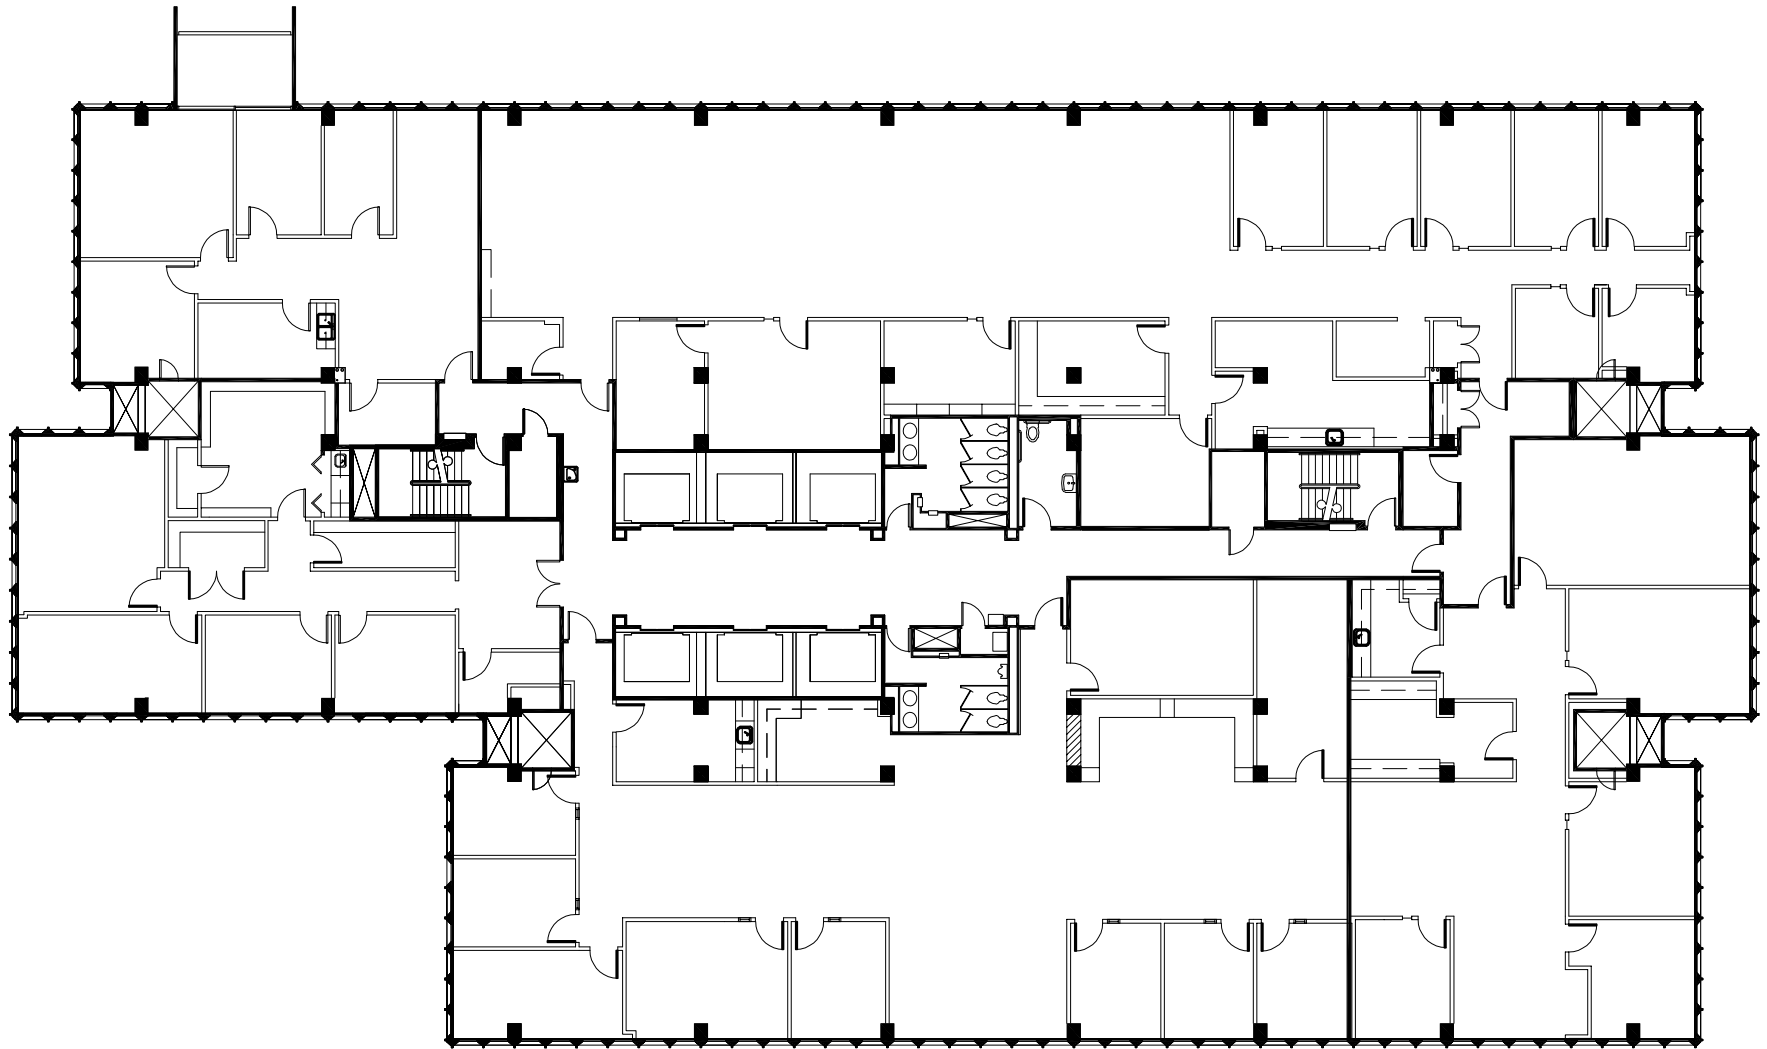


North

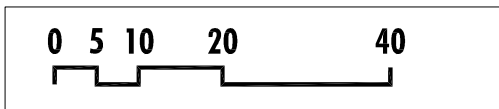


PEACHTREE  
CENTER

**NELSON** Tower 233 • 22nd Floor

**As Built**

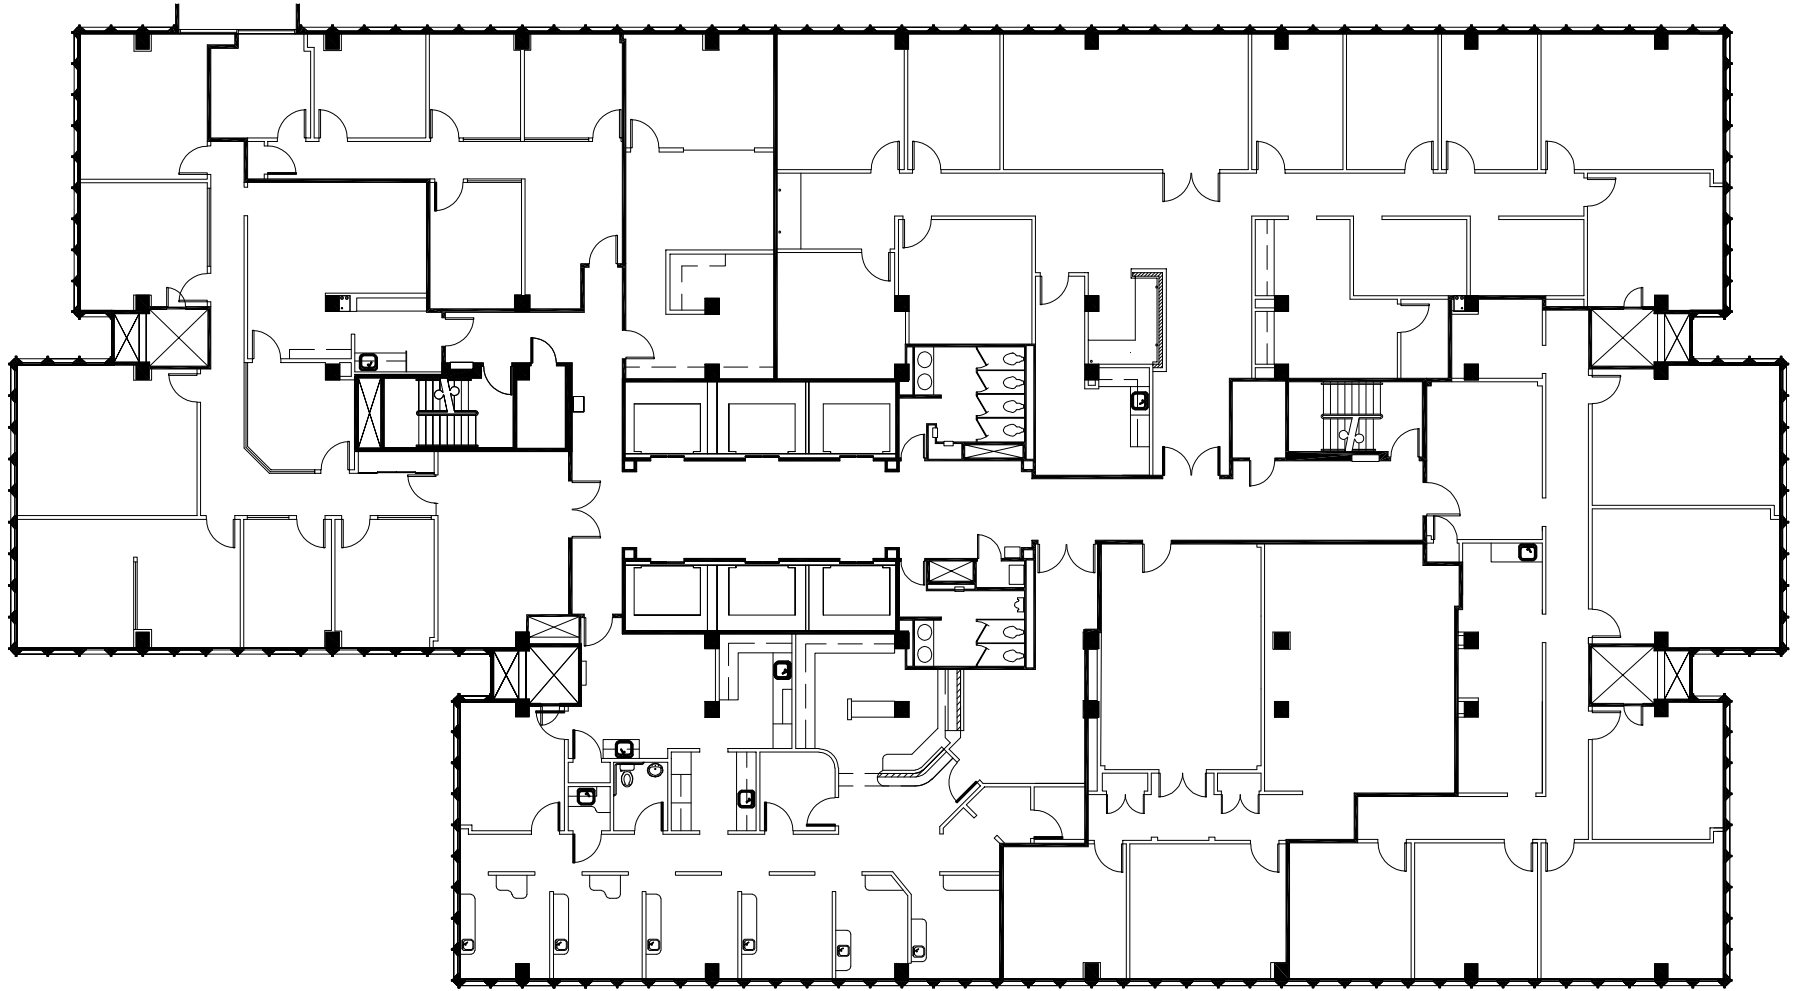


North

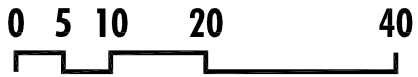

PEACHTREE  
CENTER

**NELSON** Tower 233 • 23rd Floor • 16,123 RSF

**As Built**

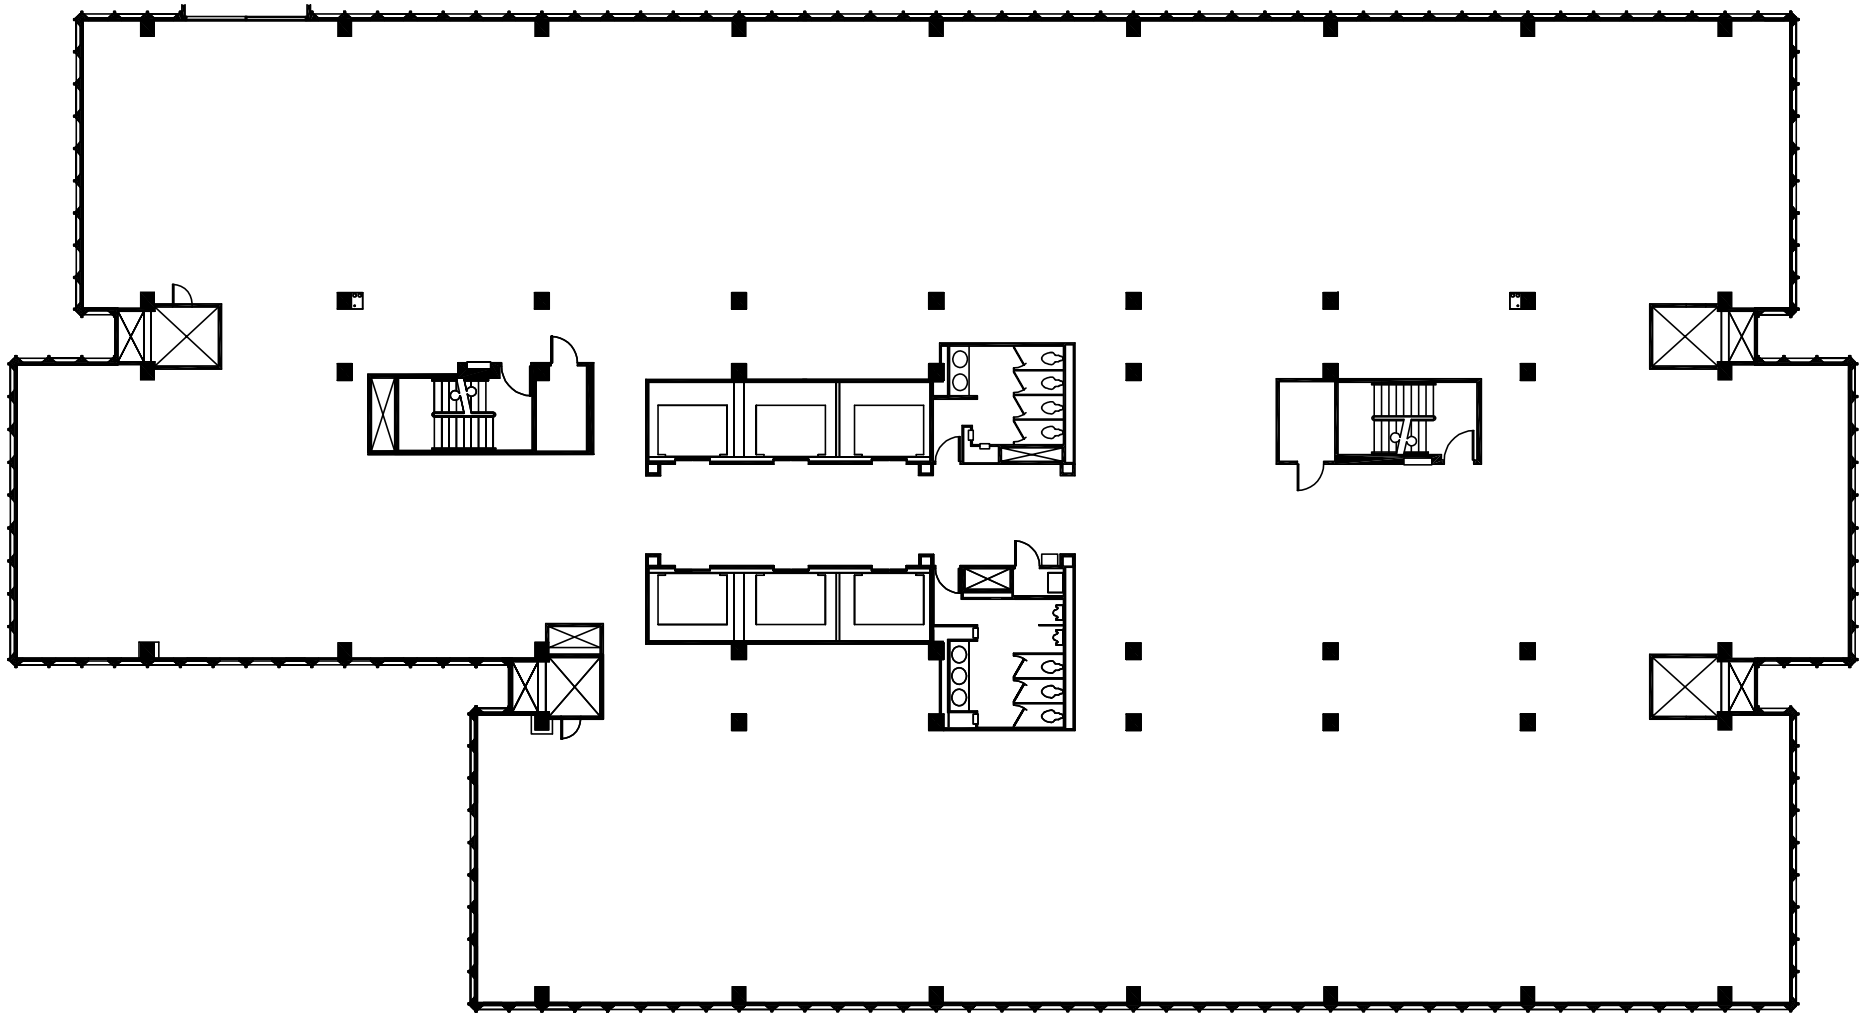

North



PEACHTREE  
CENTER

**NELSON** Tower 233 • Suite 2400 • 16,123 RSF

**As Built**