

Key Plan



North

0 5 10 20 40


This suite has not been field
verified by NELSON.




**PEACHTREE
CENTER**

NELSON Tower 229 • Suite 1250 • 5,853 RSF

As Built

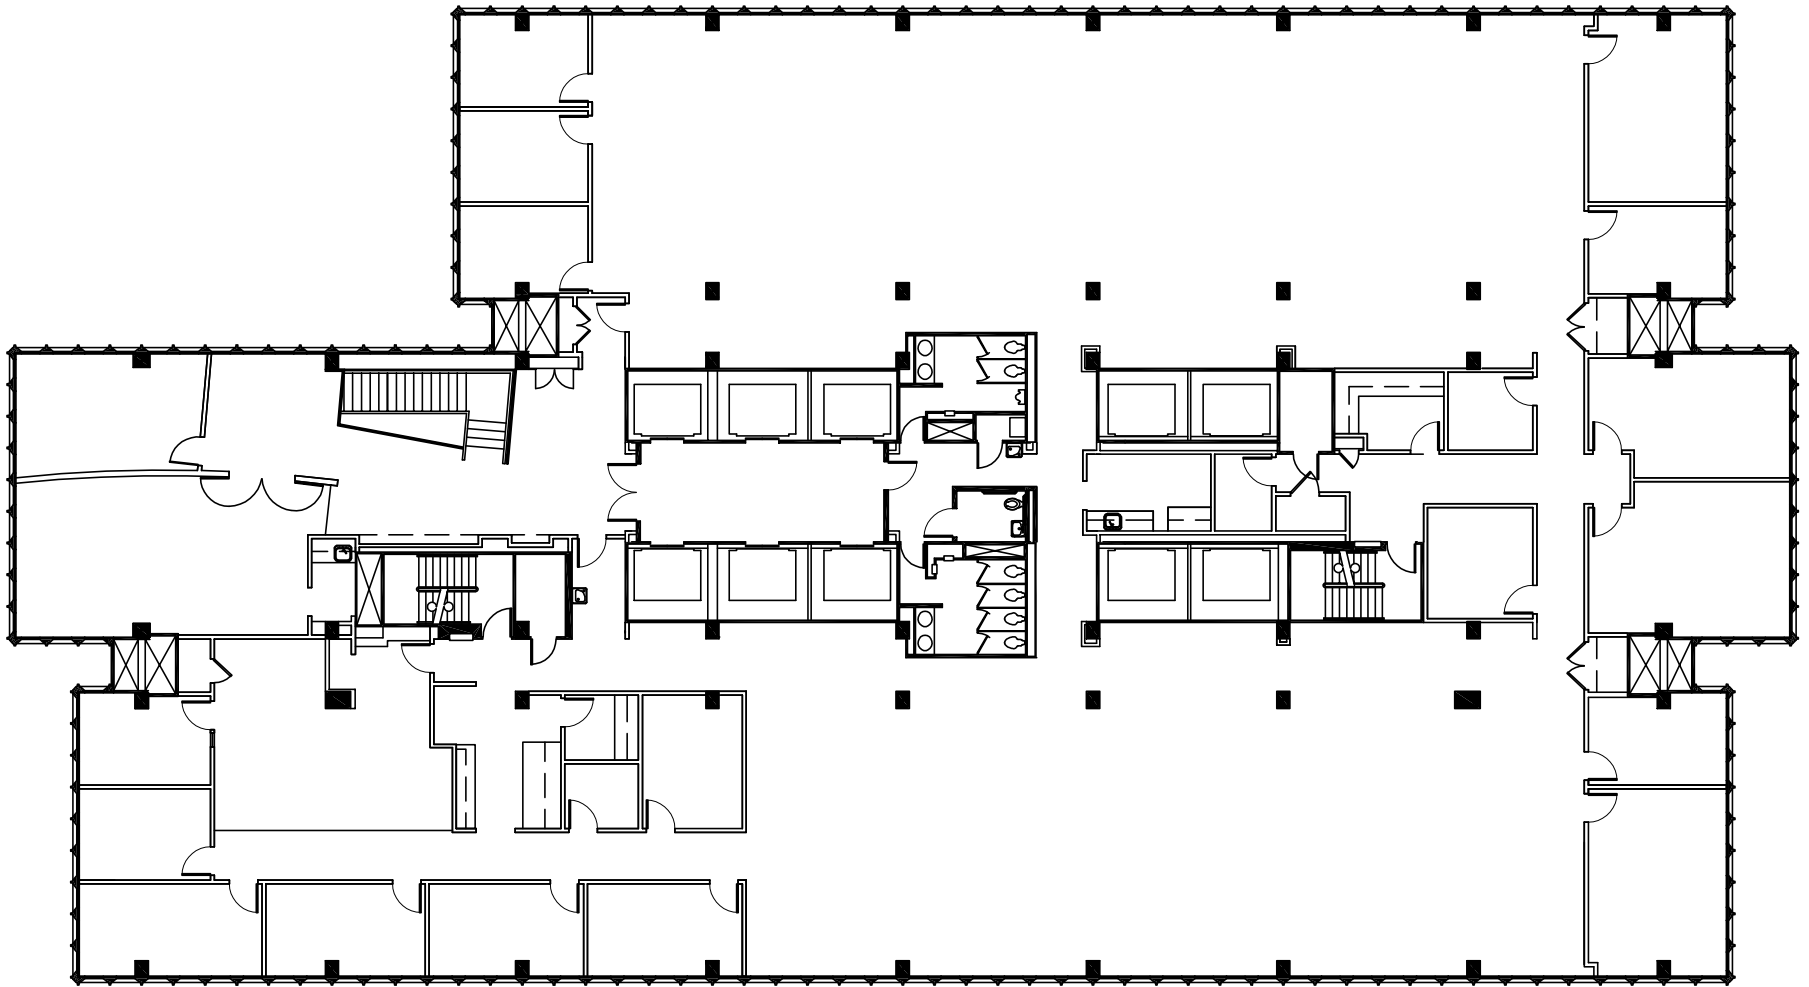

North

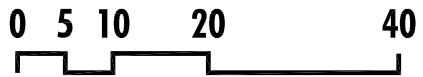

PEACHTREE
CENTER

NELSON Tower 229 • Suite 1400 • 15,571 RSF

As Built