



North

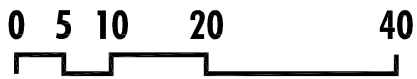


PEACHTREE
CENTER

NELSON Tower 233 • Suite 1600 • 16,237 RSF

As Built

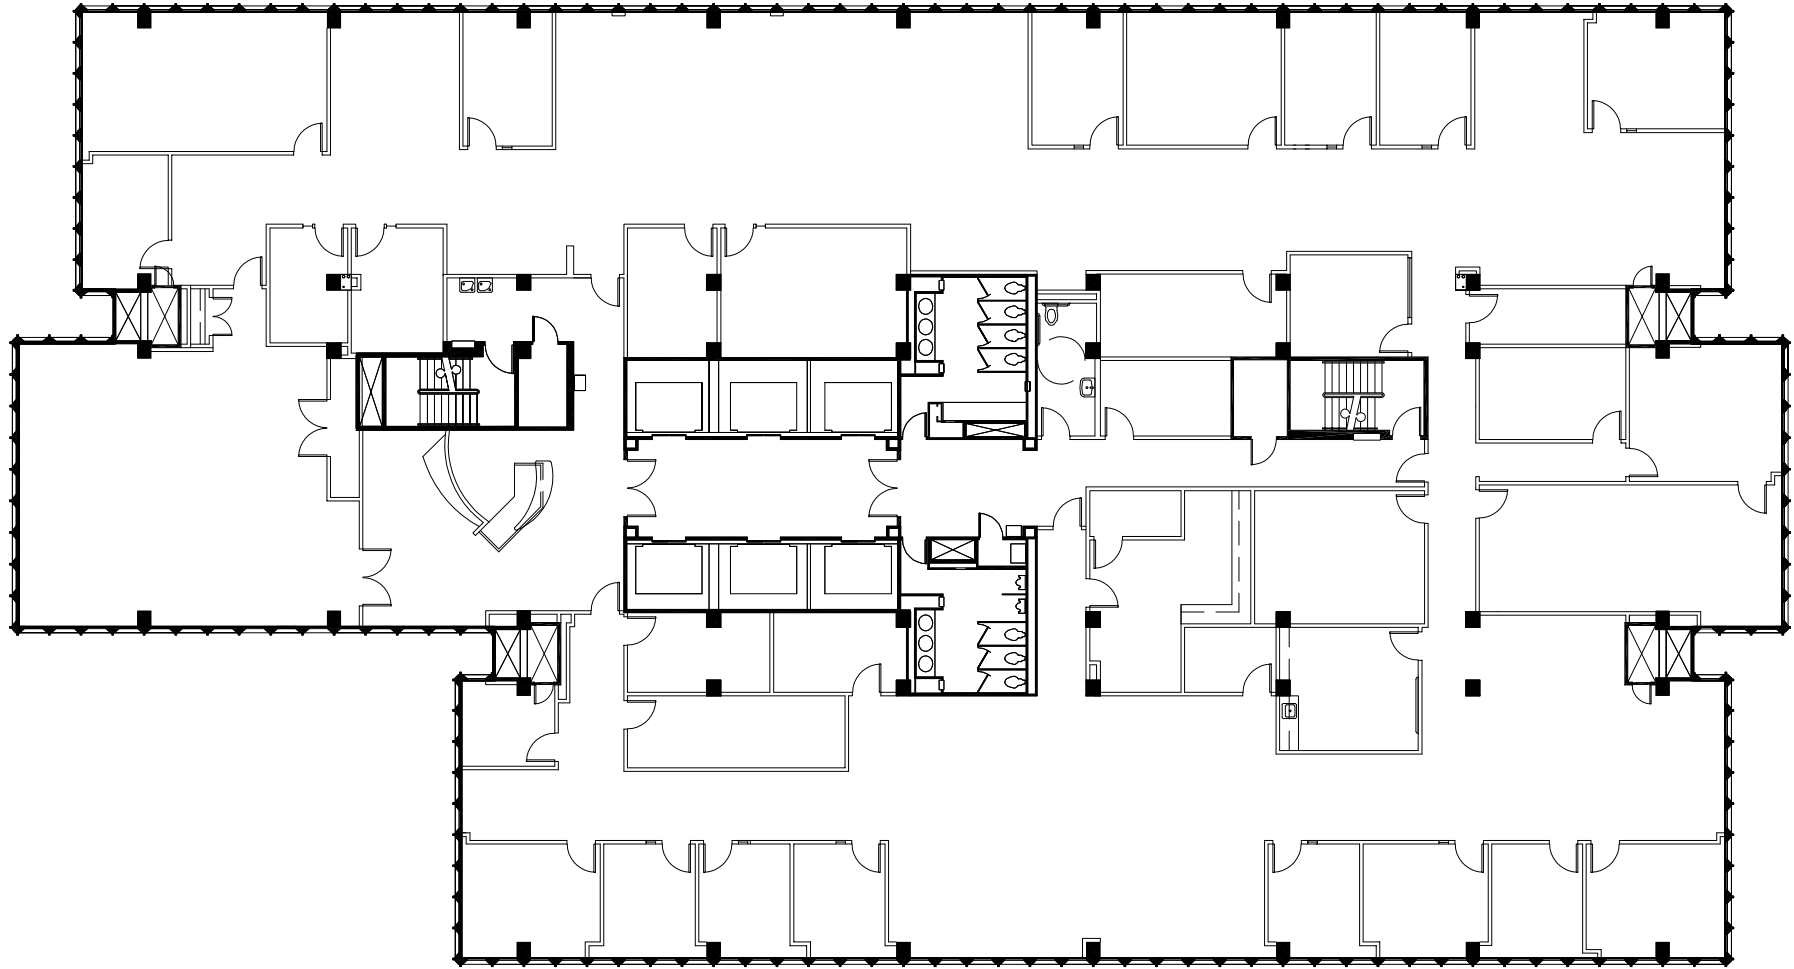


North

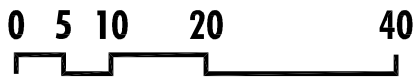


PEACHTREE
CENTER

NELSON Tower 233 • Suite 1700 • 16,237 RSF

As Built

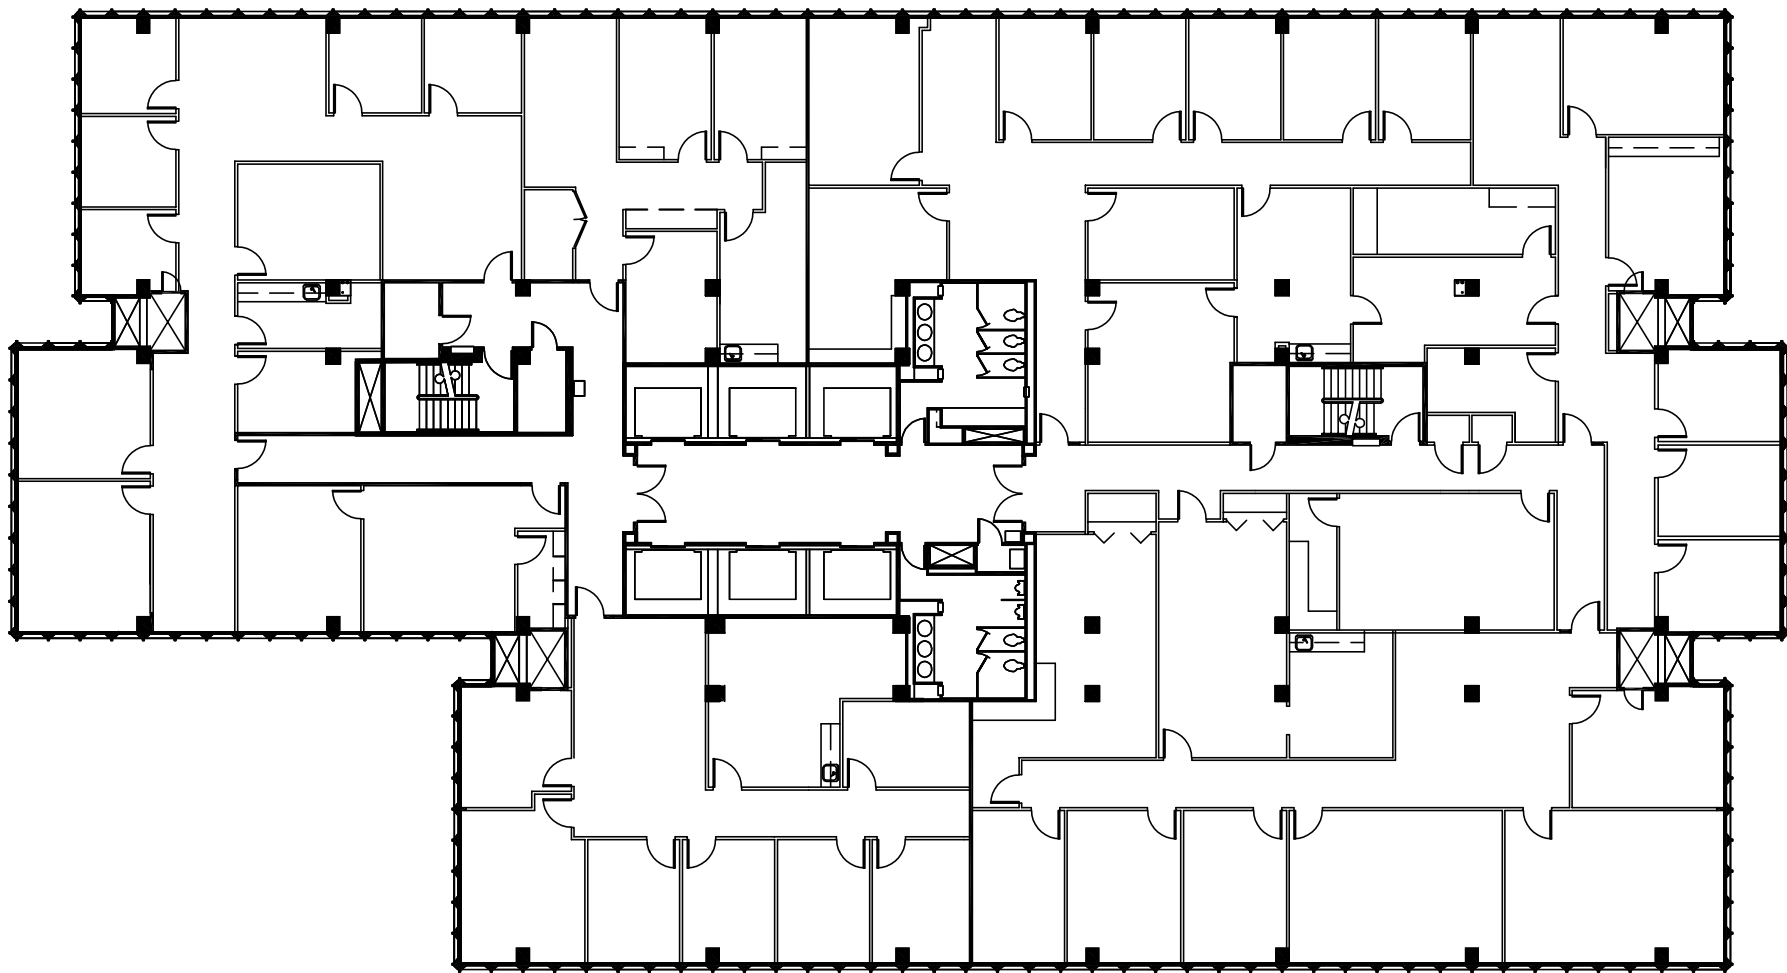


North

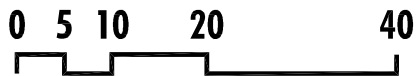


PEACHTREE
CENTER

NELSON Tower 233 • 18th Floor • 16,215 RSF

As Built

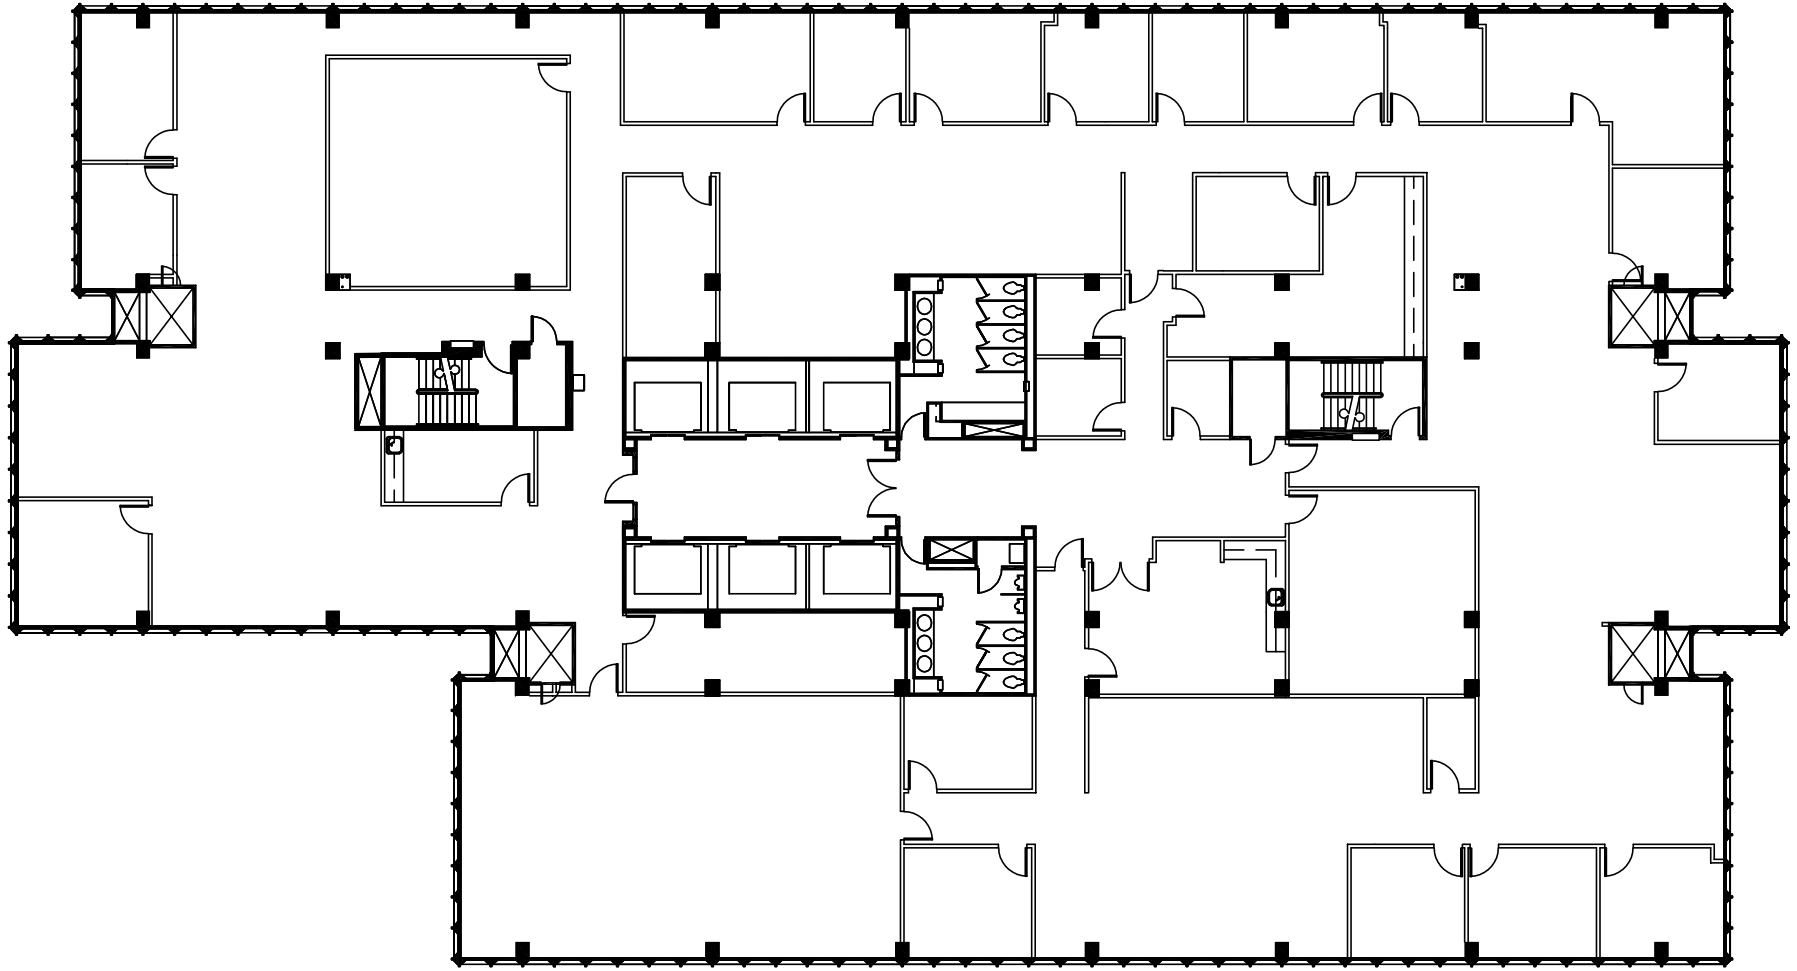


North

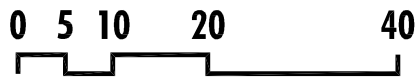


PEACHTREE
CENTER

NELSON Tower 233 • Suite 1900 • 16,191 RSF

As Built

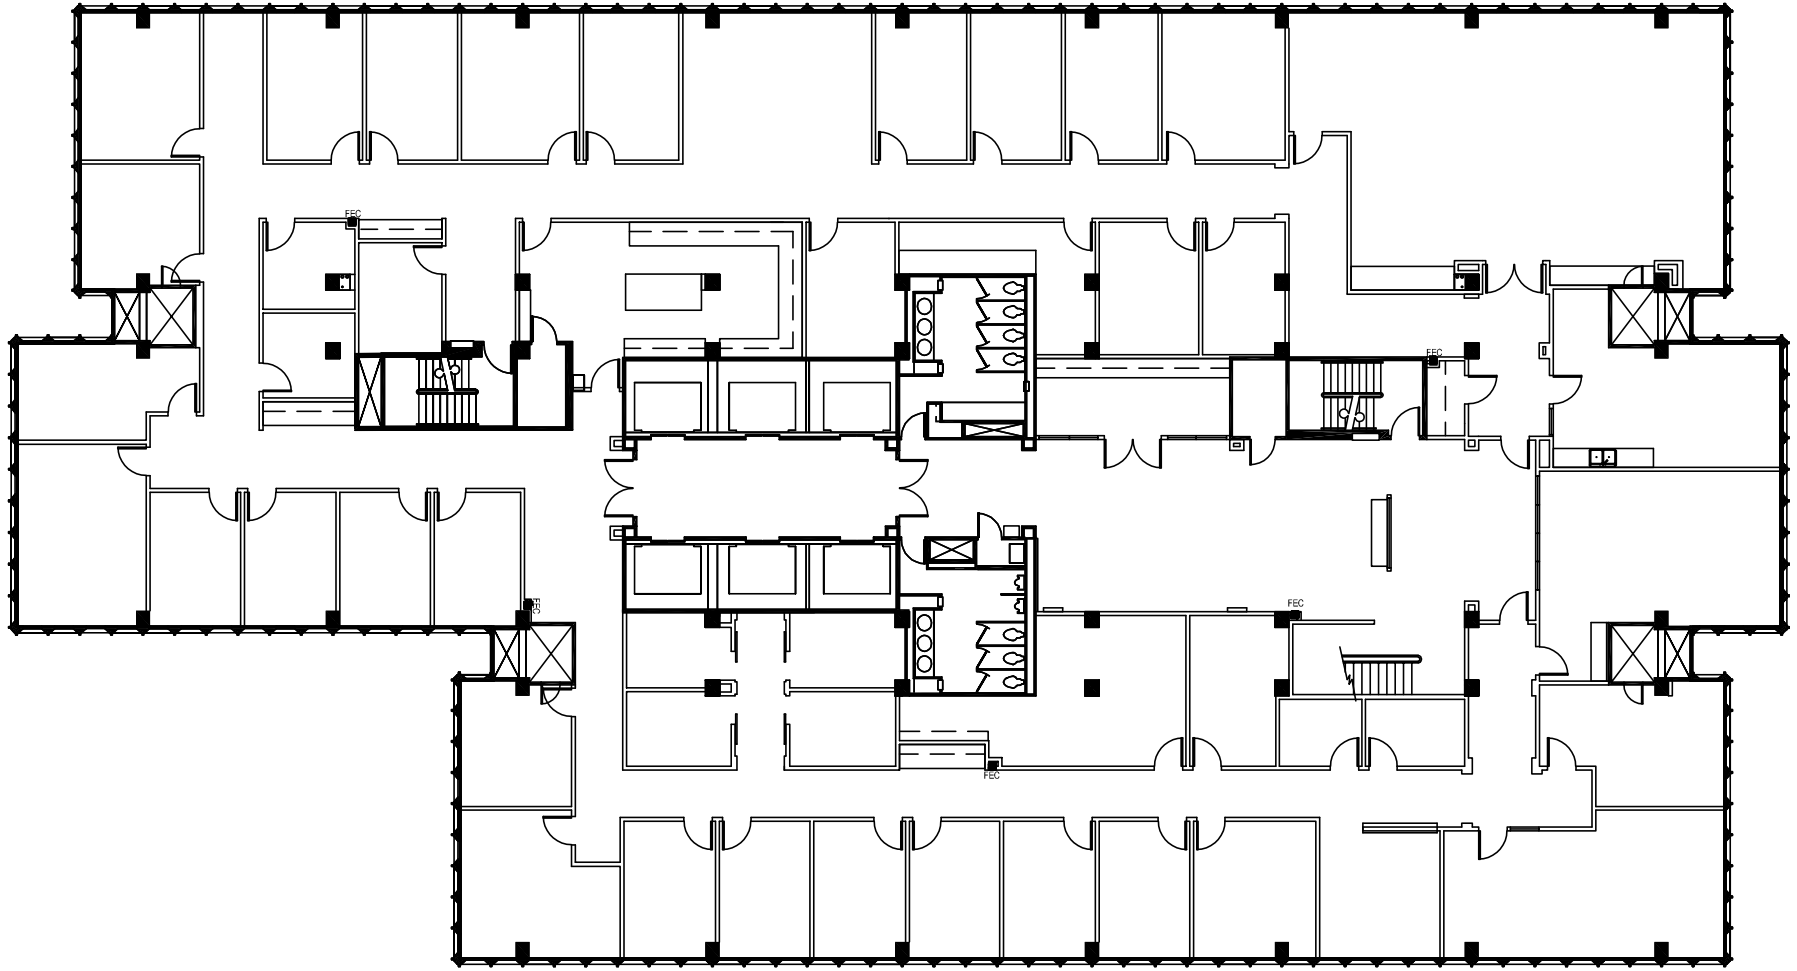


North

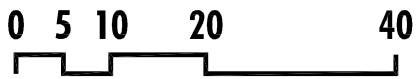


PEACHTREE
CENTER

NELSON Tower 233 • Suite 2000 • 16,191 RSF

As Built

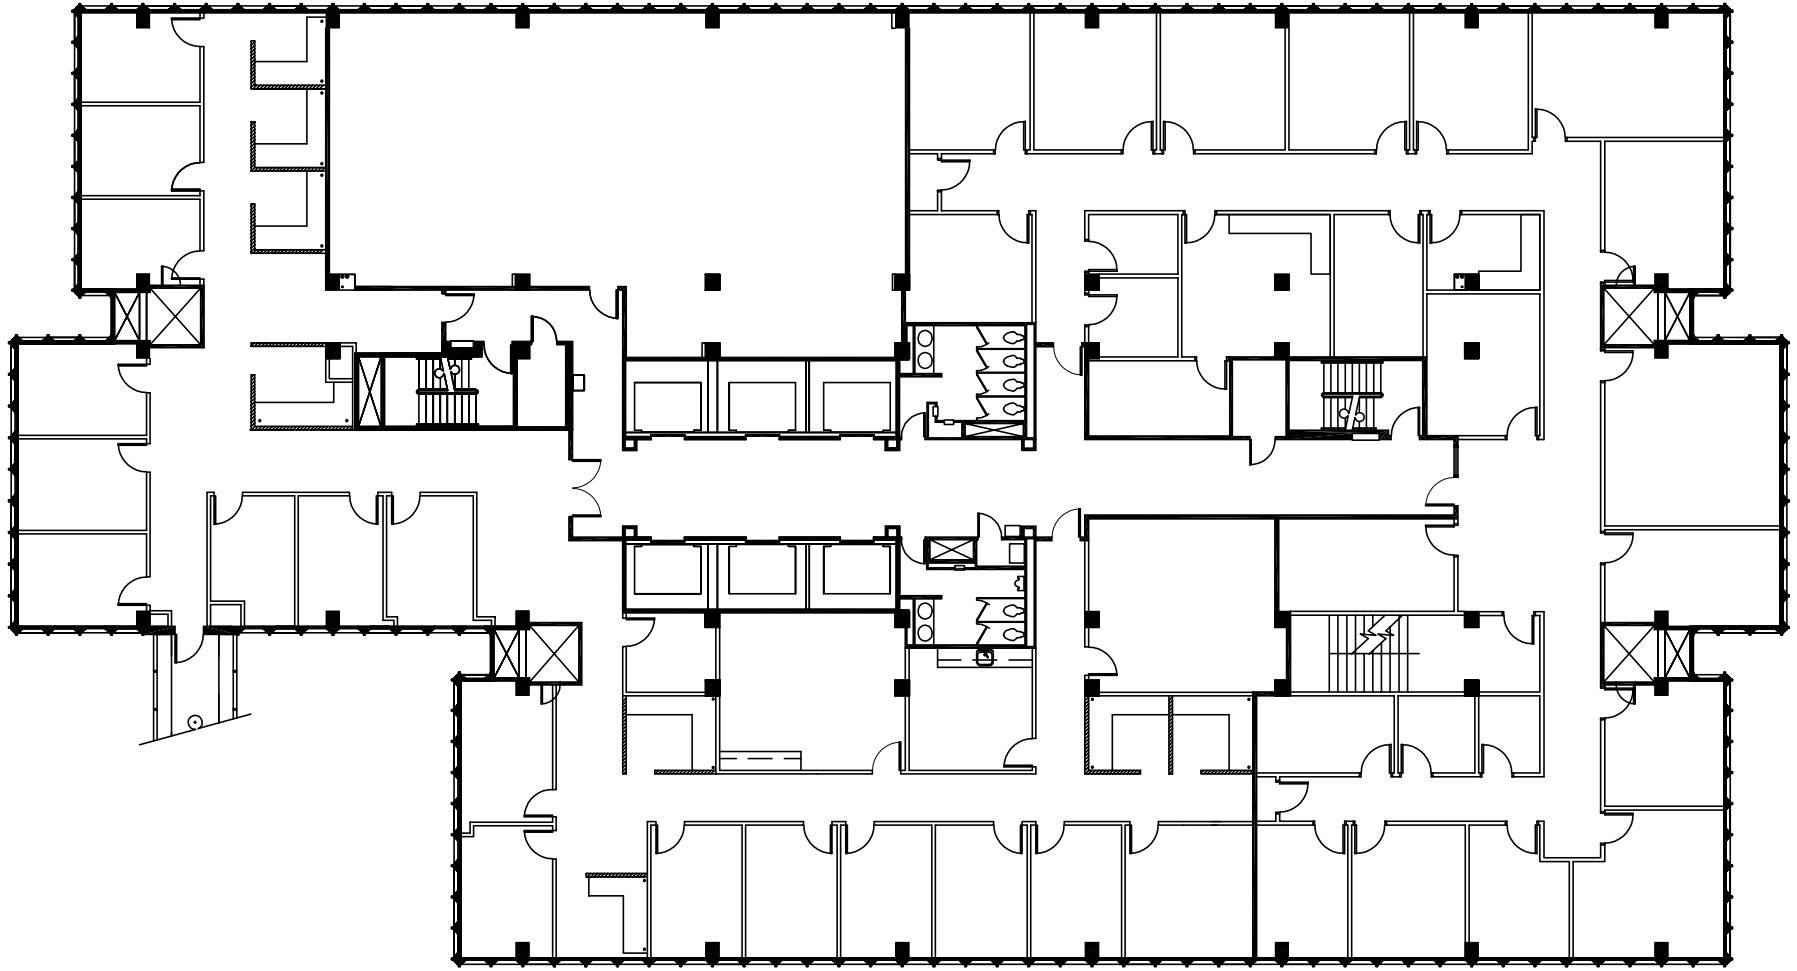

North

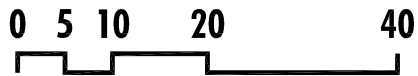

PEACHTREE
CENTER

NELSON Tower 233 • Suite 2100 • 16,191 RSF

As Built